



Task Order Request #25-008 - U-Line OCS Upgrades

|              |              |             |               |
|--------------|--------------|-------------|---------------|
| Status       | Open         | Assignees   | Greg Thurston |
| Created Date | Mar 12, 2025 | Issued Date | Mar 12, 2025  |

TASK ORDER IDENTIFICATION

|                                |                                                                                                                                                                                                                                                                                                                                                                                                                  |                     |          |
|--------------------------------|------------------------------------------------------------------------------------------------------------------------------------------------------------------------------------------------------------------------------------------------------------------------------------------------------------------------------------------------------------------------------------------------------------------|---------------------|----------|
| Contract No                    | 24-03814                                                                                                                                                                                                                                                                                                                                                                                                         |                     |          |
| Contractor Name ("Contractor") | ROCKY MOUNTAIN SYSTEMS SERVICES                                                                                                                                                                                                                                                                                                                                                                                  | Contract Start Date | 06/14/24 |
| Account Code(s)                | 20-7398.65000.5002 OCS Wire Survey: Traffic Signals and Crossing Projection (\$10,000)<br>20-7398.65000.5008 OCS Wire Survey: Hardware - Equipment (\$621,543.51)<br>20-7398.68000.8003 OCS Wire Survey: PM for Design and Construction (\$1,140,534.79)<br>20-7398.68000.8002 OCS Wire Survey: Engineering (\$21,853)<br>20-7398.65000.5004 OCS Wire Survey: Traction Power Distribution - Catenary (\$804,728) |                     |          |

1.0 SCOPE OF SERVICES

The contractor's scope letter and price estimate is hereby attached and incorporated into this Task Order

[25-008 U-Line OCS Upgrades\\_RMSS Proposal 52720-008b.pdf](#)

2.0 SCHEDULE

|                                                  |          |                                            |          |
|--------------------------------------------------|----------|--------------------------------------------|----------|
| The Substantial Completion Date for this Task is | 11/01/25 | The Final Acceptance Date for this Task is | 11/30/25 |
|--------------------------------------------------|----------|--------------------------------------------|----------|

3.0 PRICING

|                                                                                                                                                                    |          |                                                                                                                    |                                                     |
|--------------------------------------------------------------------------------------------------------------------------------------------------------------------|----------|--------------------------------------------------------------------------------------------------------------------|-----------------------------------------------------|
| The pricing agreement for this item is one of the following:                                                                                                       | Lump Sum | Invoices will be billed on a monthly basis for completed work to date. The price for this item is in the amount of | \$2,598,659.30                                      |
| Provisional Sum Amount (if applicable). Note: Any unused amount of this provisional sum amount will be deducted from the contract upon closeout of the task order. | N/A      | Independent Cost Estimate (ICE) link, if applicable                                                                | <a href="#">25-008 U-Line OCS Upgrades_ICE.xlsx</a> |

4.0 APPLICABILITY OF FEDERAL CLAUSES

|                                                                          |     |                                                                                   |    |
|--------------------------------------------------------------------------|-----|-----------------------------------------------------------------------------------|----|
| Does this Task Order include federal assistance funds which requires the | Yes | If federal assistance funds are anticipated, the UTA Civil Rights group has set a | 2% |
|--------------------------------------------------------------------------|-----|-----------------------------------------------------------------------------------|----|

## Task Order Request #25-008 - U-Line OCS Upgrades

Project: SGR398 OCS Wire Survey

application of the  
Federal Clauses  
appended as  
Exhibit D to the  
Contract?

Disadvantaged  
Business  
Enterprises (DBE)  
participation goal  
for this Task Order  
of

## UTAH TRANSIT AUTHORITY:

Required  
Signatures  
Explanation

Project Manager \$0 - 24,999  
Legal Review \$10k or greater  
Dir. of Capital Projects \$25k - 74,999  
Chief Service Dev. Ofcr. \$75k - 199,999  
Executive Director \$200,000+  
Procurement/Contracts (for all)

DocuSigned by:

Signature (Legal)

By:

Mike Bell

70E33A415BA44F6...

Name:

Mike Bell

Date:

3/17/2025

PM Approval

The costs associated with this item have been measured against the standard schedule of rates and the agreed contract pricing, (where applicable) and have been deemed consistent and appropriate for the proposed scope of work.

Signed by:

Signature (Project  
Manager)

By:

Greg Thurston

C97F990ECB99456...

Name:

Greg Thurston

Date:

3/14/2025

Director Approval

I have evaluated the content of this task order and the scope of work described in the task ordering agreement and have made the determination that this Task Order is within the scope of work contemplated and described by the contracting parties when they executed the original task ordering agreement.

Signed by:

Signature (Director)

By:

Jared Scarbrough

91ABD751A0BD4BE...

Name:

Jared Scarbrough

Date:

3/17/2025

Signature  
(Procurement)

By: \_\_\_\_\_

Name: \_\_\_\_\_

Date: \_\_\_\_\_

Signature (Chief  
Service  
Development  
Officer)

By: \_\_\_\_\_

David Hancock, Chief Service Development Officer

Date: \_\_\_\_\_

Signature  
(Executive Director)

By: \_\_\_\_\_

Jay Fox, Executive Director

Date: \_\_\_\_\_


## COMPANY:

COMPANY: ROCKY MOUNTAIN SYSTEMS SERVICES

RMSS Required  
Signature  
Explanation

- Up to \$100K – Josh Lafleur (jlafleur@modrailsystems.com)
- \$100K - \$500K – Anthony Ortolani (aortolani@modrailsystems.com)
- \$500K – \$2.5M - Shon Tulik (stulik@modrailsystems.com)
- >\$2.5M or Contract Time Extensions – Paul Reiger (prieiger@modrailsystems.com)

Signature  
(Contractor)

DocuSigned by:  
By:   
6534325C100847B  
Name: Paul Reiger  
Date: 3/14/2025



March 13<sup>th</sup>, 2025

RMSS-52720-008b

Mr. Greg Thurston  
Project Manager for Traction Power Systems  
2264 South 900 West  
Salt Lake City, UT 84119

Reference: Utah Transit Authority – Systems On-Call Services

Subject: Revised PTO022 University Line OCS and Traction Power Maintenance 2025

Greg,

Rocky Mountain Systems Services (RMSS) is pleased to provide a proposal for self-performing maintenance and upgrades to the University Line overhead catenary and traction power systems. Work under this task order is anticipated to take place in the summer of 2025. Also included in this proposal is a lump sum amount for upgrading welded track connections to bolted connections and replacing aging bonding cable.

- The lump sum price for the U-Line OCS Maintenance is **\$2,276,408.82**
- The lump sum price for Track Connection Rehabilitation is: **\$322,250.48**

The scope of work covered in this proposal is as follows:

#### **General Description**

In order to maximize the utilization of track access and shutdown activities UTA has coordinated the following elements with RMSS to be completed during scheduled system outages of the University Line in the summer of 2025:

- Rice Interlocking crossover OCS reconfiguration
- Overhead catenary system (OCS) maintenance from 900E to Health Sciences Station
- Auto-tensioner Tensorex C+ upgrades from 900E to Health Sciences Station
- Welded to bolted rail connection rehabilitation from Main Street to Health Sciences Station

Each element will be described in detail in the attached exhibits and sections below.

#### **1. Rice Interlocking OCS Reconfiguration**

The diamond crossover at Rice Interlocking is being replaced during the scheduled system outage in the summer of 2025. The geometry of the trackwork is being modified in order to provide some extra distance between the mainline curve to the south and the south end of the crossover special trackwork. This modification to the crossover geometry requires some minor OCS reconfiguration through the crossovers.




### **Rice Interlocking OCS Reconfiguration Installation**

The following installation activities outlined below and shown in Figure 1 are included in the scope of this proposal:

- The main-line air-break assemblies will be removed on both tracks. The existing messenger wire cut-in insulators on both tracks will be jumpered to maintain continuity. Existing cut-in insulators on the contact wires will be spliced to a section of new contact wire a minimum of 6-feet long.
- Repurpose arial head-guy hardware. Knuckles will be moved 12-feet north to align over new crossover centerline. The crossover knuckles will be reconfigured per drawing "OC147".
- Existing crossover WR#13 termination will be moved from structure 4114 to structure 4115-1.
- Existing crossover WR#14 termination will be moved from structure 4114 to structure 4115.
  - a. The pole deflection for structures 4115 and 4115-1 at the top of pole will be a maximum of 2 3/8" toward the track and 1 7/8" perpendicular to the track under the worst-case operating conditions.
- New section insulators on the EB and WB tracks are to be installed 46 feet south of structure 4116. The existing section insulators on the crossover wires will be relocated per the details given on sheet "OC212".
- The CA-07A and CA-07B cantilevers at structures 4115 and 4115-1 to be modified as shown on sheets "OC129" and "OC130". Staggers to be adjusted as shown on the OCS layout plan.
- Pre-assemble two (2) new CA-11A type cantilevers.
- The CA-07A and CA-07B cantilevers at structure 4116 to be replaced with CA-11A cantilevers. The surge arrester to be relocated as required to achieve the new messenger wire height.
- The CA-10 cantilevers at structures 4115 and 4115-1 that support the crossover wires to be removed.
- New hangers and in-span jumpers are to be installed to achieve the designed wire height.
  - a. The existing insulated cables of the feeders and the surge arresters will remain. 500 MCM Superflex bare copper jumper cable and clamps will be installed new.
- Contact wire bridge assemblies to be installed at crossover and mainline contact wire crossing points

Figure 1

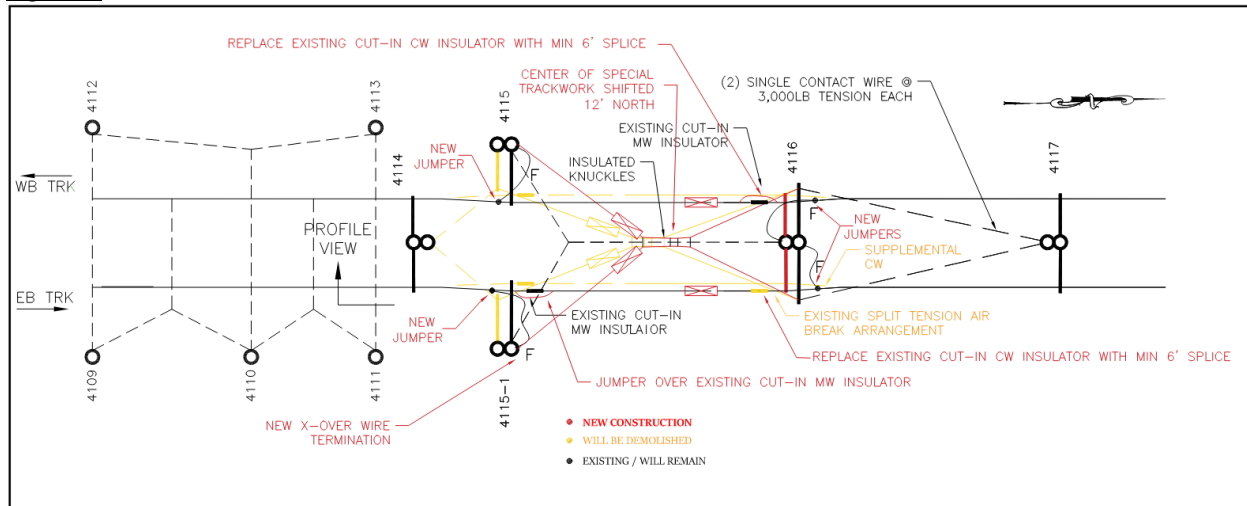

## 2. Overhead Catenary System (OCS) Maintenance

Included in this scope of work is the maintenance of elements of the OCS system on the University Line between 900E and the Medical Center.

### Installation

The OCS maintenance scope includes:

- Insulated Saddle and Hanger Replacement
  - Replacement of aging insulated messenger wire saddles on tangent wire sections between OCS poles 4069 to 5079 as shown on "Appendix D – University Line OCS Upgrades and Maintenance Exhibit"
- Replacement of worn contact wire sections including the hangers at the following locations:
  - Between OCS poles 4069 to 4094 (~2,100') on the eastbound track
  - At OCS pole 5053 adjacent to'. Douglas Station (~20') on the eastbound track
  - Between OCS Poles 5057 to 5059 (~100') on the eastbound track
  - Between OCS Poles 5077 to 5078 (~100') on the westbound track
- Replacement of pole mounted surge arrestors at the following locations:
  - Four (4) surge arrestors at feeder Pole 4070
  - Two (2) surge arrestors at feeder Pole 4115 / 4115-1
  - Two (2) surge arrestors at feeder Pole 4116
  - Four (4) surge arrestors at feeder Pole 5078
- Replacement of mid-point anchor assemblies at the following locations:
  - At OCS pole 4093
  - At OCS pole 4095
  - At OCS pole 5017
  - At OCS pole 5019
  - At OCS pole 5051
  - At OCS Pole 5054

### 3. Tensorex C+ OCS Spring Tensioner Upgrades

Included in this scope of work is the upgrade of existing balance weight assemblies from their current configuration to the Tensorex auto-tensioning devices.

#### Installation

The scope of the Tensorex C+ spring tensioner upgrade work is as follows:

- Prior to setting new spring tensioners at their final condition, the midpoint anchor assembly tension and the cantilever along track movement to be verified to original design condition at the following structures:
  - 4094 EB & WB
  - 4051 EB & WB
  - 4052 EB & WB
  - 5018 EB & WB
  - 5052 EB & WB
  - 5053 EB & WB
- Existing **reduced** tension SCAT balance weight termination assemblies will be replaced with Tensorex C+ spring tensioners at the following structures,
  - 4127
  - 4128
  - 5036
  - 5037
- Reduced Tension Installation Details:
  - Termination height will remain the same
  - Existing messenger and contact wire termination clamps to remain on the conductors and reused in new termination arrangements.
  - Termination insulators are to be located at 4'-0" minimum horizontal offset from super-elevated track centerline.
  - Hangers are to be located and adjusted or new hangers to be installed to cause the out of running contact wire to be above the in-running contact wire level over the entire span.
  - Equalizing jumpers to be replaced as necessary to enable full along track movement without binding or lifting and to be adjusted to avoid fouling the pantograph under any operating conditions.
- Existing **nominal** tension SCAT balance weight termination assemblies will be replaced with Tensorex C+ spring tensioners at the following structures,
  - 4068
  - 4069
  - 4071
  - 4072
  - 4107
  - 4108
  - 4124
  - 4125
  - 5039

- 5040
- 5079
- 5080
- Nominal Tension Installation Details:
  - Messenger wire termination height to be increased by 12" from existing termination height.
  - Contact wire termination height to be decreased by 11" from existing termination height.
  - Existing messenger and contact wire termination clamps to remain on the conductors and reused in new termination arrangements.
  - Termination insulators are to be located at 4'-0" minimum horizontal offset from super-elevated track centerline.
  - Hangers are to be located and adjusted or new hangers to be installed to cause the out of running contact wire to be above the in-running contact wire level over the entire span.
  - Equalizing jumpers to be replaced as necessary to enable full along track movement without binding or lifting and to be adjusted to avoid fouling the pantograph under any operating conditions.
- A detailed workplan includes the means and methods of removing balance weight stack, rigging systems during termination replacement, and final setting of spring tensioners to be submitted for RMSS/UTA approval.

#### 4. Welded to Bolted Rail Connection Upgrades from Main Street to Health Sciences Station

RMSS will perform the following rehabilitation to embedded track connection locations as follows:

##### Cactus St. & 400 S - 3+00 (Location 1)

RMSS will remove and install the following items:

|        | Existing Connections | Cembre | Lugs | Cable | Track Box |
|--------|----------------------|--------|------|-------|-----------|
| Box #1 | 2x500 Kcmil          | 3      | 2    |       | By others |
| Box #2 | 4x500 Kcmil          | 5      | 4    | ~60'  | By others |
| Box #3 | 2x500 Kcmil          | 3      | 2    | ~80'  | By others |

\*Cembre quantities include one spare per track box.

##### 200 E & 400 S - 19+41 (Location 2)

RMSS will remove and install the following items:

|        | Existing Connections | Cembre | Lugs | Cable | Track Box |
|--------|----------------------|--------|------|-------|-----------|
| Box #1 | 3x500 Kcmil          | 4      | 3    | ~120' | By others |





|          |             |     |     |       |           |
|----------|-------------|-----|-----|-------|-----------|
| Box #2   | 3x500 Kcmil | 4   | 3   |       | By others |
|          |             |     |     | N/A   |           |
| Box #3   | 3x500 Kcmil | 4   | 3   |       | By others |
|          |             |     |     | ~100' |           |
| Pull Box | N/A         | N/A | N/A |       | N/A       |
|          |             |     |     | ~100' |           |
| Box #6   | 3x500 Kcmil | 4   | 3   |       | By others |
|          |             |     |     | N/A   |           |
| Box #5   | 3x500 Kcmil | 4   | 3   |       | By others |
|          |             |     |     | ~120' |           |
| Box #4   | 3x500 Kcmil | 4   | 3   |       | By others |

\*Cembre quantities include one spare per track box.

#### 400 E & 400 S - 36+50 (Location 3)

RMSS will remove and install the following items:

|        | Existing Connections | Cembre | Lugs | Cable | Track Box |
|--------|----------------------|--------|------|-------|-----------|
| Box #1 | 2x500 Kcmil          | 3      | 2    |       | By others |
|        |                      |        |      | ~80'  |           |
| Box #2 | 4x500 Kcmil          | 5      | 4    |       | By others |
|        |                      |        |      | ~60'  |           |
| Box #3 | 4x500 Kcmil          | 5      | 4    |       | By others |
|        |                      |        |      | ~80'  |           |
| Box #4 | 2x500 Kcmil          | 3      | 2    |       | By others |

\*Cembre quantities include one spare per track box.

#### Trolley Square - 53+50 (Location 4)

RMSS will remove and install the following items:

|        | Existing Connections | Cembre | Lugs | Cable | Track Box |
|--------|----------------------|--------|------|-------|-----------|
| Box #1 | 2x500 Kcmil          | 3      | 2    |       | By others |
|        |                      |        |      | ~80'  |           |
| Box #2 | 4x500 Kcmil          | 5      | 4    |       | By others |
|        |                      |        |      | ~60'  |           |
| Box #3 | 4x500 Kcmil          | 5      | 4    |       | By others |
|        |                      |        |      | ~80'  |           |
| Box #4 | 2x500 Kcmil          | 3      | 2    |       | By others |

\*Cembre quantities include one spare per track box.

#### 200 W – Sta. 730+00 (Location 5)



RMSS will provide the following items for future installation:

|        | Existing Connections | Cembre | Lugs | Cable | Track Box |
|--------|----------------------|--------|------|-------|-----------|
| Box #1 | 2x500 Kcmil          | 3      | 2    |       | By others |
| Box #2 | 4x500 Kcmil          | 5      | 4    | ~80'  | By others |
| Box #3 | 4x500 Kcmil          | 5      | 4    | ~60'  | By others |
| Box #4 | 2x500 Kcmil          | 3      | 2    | ~80'  | By others |

\*Cembre quantities include one spare per track box.

#### 700 S – Sta 745+20 (Location 6)

RMSS will provide the following items for future installation:

|        | Existing Connections | Cembre | Lugs | Cable | Track Box |
|--------|----------------------|--------|------|-------|-----------|
| Box #1 | 2x500 Kcmil          | 3      | 2    |       | By others |
| Box #2 | 4x500 Kcmil          | 5      | 4    | ~80'  | By others |
| Box #3 | 4x500 Kcmil          | 5      | 4    | ~60'  | By others |
| Box #4 | 2x500 Kcmil          | 3      | 2    | ~80'  | By others |

\*Cembre quantities include one spare per track box.

#### 700 S – Sta 748+45 (Location 7)

RMSS will provide the following items for future installation:

|        | Existing Connections | Cembre | Lugs | Cable | Track Box |
|--------|----------------------|--------|------|-------|-----------|
| Box #1 | 2x500 Kcmil          | 3      | 2    |       | By others |
| Box #2 | 4x500 Kcmil          | 5      | 4    | ~80'  | By others |
| Box #3 | 4x500 Kcmil          | 5      | 4    | ~60'  | By others |
| Box #4 | 2x500 Kcmil          | 3      | 2    | ~80'  | By others |

\*Cembre quantities include one spare per track box.

#### 500 S – Sta. 765+50 (Location 8)



RMSS will provide the following items for future installation:

|        | Existing Connections | Cembre | Lugs | Cable | Track Box |
|--------|----------------------|--------|------|-------|-----------|
| Box #1 | 2x500 Kcmil          | 3      | 2    |       | By others |
| Box #2 | 4x500 Kcmil          | 5      | 4    | ~80'  | By others |
| Box #3 | 4x500 Kcmil          | 5      | 4    | ~60'  | By others |
| Box #4 | 2x500 Kcmil          | 3      | 2    | ~80'  | By others |

\*Cembre quantities include one spare per track box.

#### Main St. & 300 S – 782+55 (Location 9)

RMSS will provide the following items for future installation:

|          | Existing Connections | Cembre | Lugs | Cable | Track Box |
|----------|----------------------|--------|------|-------|-----------|
| Box #1   | 3x500 Kcmil          | 4      | 3    |       | By others |
| Box #3   | 3x500 Kcmil          | 4      | 3    | ~120' | By others |
| Box #2   | 3x500 Kcmil          | 4      | 3    | N/A   | By others |
| Pull Box | N/A                  | N/A    | N/A  | N/A   | N/A       |
| Box #5   | 3x500 Kcmil          | 4      | 3    | N/A   | By others |
| Box #6   | 3x500 Kcmil          | 4      | 3    | N/A   | By others |
| Box #4   | 3x500 Kcmil          | 4      | 3    | ~120' | By others |

\*Cembre quantities include one spare per track box.

#### Temple Square – Sta. 819+11 (Location 10)

RMSS will provide the following items for future installation:

|        | Existing Connections | Cembre | Lugs | Cable | Track Box |
|--------|----------------------|--------|------|-------|-----------|
| Box #1 | 2x500 Kcmil          | 3      | 2    |       | By others |
| Box #2 | 4x500 Kcmil          | 5      | 4    | ~80'  | By others |
| Box #3 | 4x500 Kcmil          | 5      | 4    | ~60'  | By others |



|        |             |   |   |      |           |
|--------|-------------|---|---|------|-----------|
|        |             |   |   | ~80' |           |
| Box #4 | 2x500 Kcmil | 3 | 2 |      | By others |

\*Cembre quantities include one spare per track box.

#### Delta Center – Sta. 835+22 (Location 11)

RMSS will provide the following items for future installation:

|        | Existing Connections | Cembre | Lugs | Cable | Track Box |
|--------|----------------------|--------|------|-------|-----------|
| Box #1 | 2x500 Kcmil          | 3      | 2    |       | By others |
| Box #2 | 4x500 Kcmil          | 5      | 4    | ~80'  | By others |
| Box #3 | 4x500 Kcmil          | 5      | 4    | ~60'  | By others |
| Box #4 | 2x500 Kcmil          | 3      | 2    | ~80'  | By others |

\*Cembre quantities include one spare per track box.

#### Delta Center – Sta.837+80 (Location 12)

RMSS will remove and install the following items:

|          | Existing Connections | Cembre | Lugs | Cable | Track Box |
|----------|----------------------|--------|------|-------|-----------|
| Box #1   | 3x500 Kcmil          | 4      | 3    |       | By others |
| Box #4   | 3x500 Kcmil          | 4      | 3    | ~120' | By others |
| Box #2   | 3x500 Kcmil          | 4      | 3    | N/A   | By others |
| Pull Box | N/A                  | N/A    | N/A  | N/A   | N/A       |
| Box #3   | 3x500 Kcmil          | 4      | 3    | N/A   | By others |

\*Cembre quantities include one spare per track box.

#### Main Temple - Sta.793+01 (Location 13)

RMSS will provide the following items for future installation:

|        | Existing Connections | Cembre | Lugs | Cable | Track Box |
|--------|----------------------|--------|------|-------|-----------|
| Box #1 | 2x500 Kcmil          | 3      | 2    |       | By others |
| Box #2 | 4x500 Kcmil          | 5      | 4    | ~80'  | By others |
|        |                      |        |      | ~60'  |           |



|        |             |   |   |      |           |
|--------|-------------|---|---|------|-----------|
| Box #3 | 4x500 Kcmil | 5 | 4 |      | By others |
|        |             |   |   | ~80' |           |
| Box #4 | 2x500 Kcmil | 3 | 2 |      | By others |

\*Cembre quantities include one spare per track box.

#### Main Temple & 100 S Sta.796+85 (Location 14)

RMSS will provide the following items for future installation:

|        | Existing Connections | Cembre | Lugs | Cable | Track Box |
|--------|----------------------|--------|------|-------|-----------|
| Box #1 | 2x500 Kcmil          | 3      | 2    |       | By others |
|        |                      |        |      | ~80'  |           |
| Box #2 | 4x500 Kcmil          | 5      | 4    |       | By others |
|        |                      |        |      | ~60'  |           |
| Box #3 | 4x500 Kcmil          | 5      | 4    |       | By others |
|        |                      |        |      | 80'   |           |
| Box #4 | 2x500 Kcmil          | 3      | 2    |       | By others |

\*Cembre quantities include one spare per track box.

#### Location 15 – 9<sup>th</sup> South TPS (Location 15)

RMSS will provide the following items for future installation:

|          | Existing Connections | Cembre | Lugs | Cable | Track Box |
|----------|----------------------|--------|------|-------|-----------|
| Box #1   | 3x500 Kcmil          | 4      | 3    |       | By others |
|          |                      |        |      | ~120' |           |
| Box #5   | 3x500 Kcmil          | 4      | 3    |       | By others |
|          |                      |        |      | N/A   |           |
| Box #2   | 3x500 Kcmil          | 4      | 3    |       | By others |
|          |                      |        |      | N/A   |           |
| Pull Box | N/A                  | N/A    | N/A  |       | N/A       |
|          |                      |        |      | N/A   |           |
| Box #4   | 3x500 Kcmil          | 4      | 3    |       | By others |
|          |                      |        |      | N/A   |           |
| Box #6   | 3x500 Kcmil          | 4      | 3    |       | By others |
|          |                      |        |      | ~120' |           |
| Box #3   | 3x500 Kcmil          | 4      | 3    |       | By others |

\*Cembre quantities include one spare per track box.

#### 500 S & 1200 E (Location 16)

RMSS will remove and install the following items:

|  | Existing Connections | Cembre | Lugs | Cable | Track Box |
|--|----------------------|--------|------|-------|-----------|
|--|----------------------|--------|------|-------|-----------|



|        |             |   |   |      |           |
|--------|-------------|---|---|------|-----------|
| Box #1 | 2x500 Kcmil | 3 | 2 |      | By others |
| Box #2 | 4x500 Kcmil | 5 | 4 | ~80' | By others |
| Box #3 | 4x500 Kcmil | 5 | 4 | ~60' | By others |
| Box #4 | 2x500 Kcmil | 3 | 2 | ~80' | By others |

\*Cembre quantities include one spare per track box.

### 500 S & 1300 E – 101+80 (Location 17)

RMSS will remove and install the following items:

|        | Existing Connections | Cembre | Lugs | Cable to IB | Track Box |
|--------|----------------------|--------|------|-------------|-----------|
| Box #1 | 2x500 Kcmil          | 3      | 2    | ~230'       | By others |
| Box #2 | 2x500 Kcmil          | 3      | 2    | ~180'       | By others |
| Box #5 | 2x500 Kcmil          | 3      | 2    | ~130'       | By others |
| Box #6 | 2x500 Kcmil          | 3      | 2    | ~90'        | By others |
| IB     | 4x500 Kcmil          | N/A    | 4    | N/A         | N/A       |

|        | Existing Connections | Cembre | Lugs | Cable to IB | Track Box |
|--------|----------------------|--------|------|-------------|-----------|
| Box #8 | 2x500 Kcmil          | 3      | 2    | ~230'       | By others |
| Box #7 | 2x500 Kcmil          | 3      | 2    | ~180'       | By others |
| Box #4 | 2x500 Kcmil          | 3      | 2    | ~130'       | By others |
| Box #3 | 2x500 Kcmil          | 3      | 2    | ~90'        | By others |
| IB     | 4x500 Kcmil          | N/A    | 4    | N/A         | N/A       |

\*Cembre quantities include one spare per track box.

### TPS E4 – Sta. 173+00 (Location 20)

RMSS will remove and install the following items:

|        | Existing Connections | Cembre | Lugs | Cable to IB | Track Box |
|--------|----------------------|--------|------|-------------|-----------|
| Box #1 | 2x500 Kcmil          | 3      | 2    | ~180'       | By others |



|        |                      |        |      |             |           |
|--------|----------------------|--------|------|-------------|-----------|
| Box #2 | 2x500 Kcmil          | 3      | 2    | ~100'       | By others |
| IB     | 4x500 Kcmil          | N/A    | 4    | N/A         | N/A       |
|        | Existing Connections | Cembre | Lugs | Cable to IB | Track Box |
| Box #3 | 2x500 Kcmil          | 3      | 2    | ~100'       | By others |
| Box #4 | 2x500 Kcmil          | 3      | 2    | ~180'       | By others |
| IB     | 4x500 Kcmil          | N/A    | 4    | N/A         | N/A       |

\*Cembre quantities include one spare per track box.

#### TPS E5 – Sta. 196+00 Double XO (Location 21)

RMSS will remove and install the following items:

|         |                      |        |      |       |           |
|---------|----------------------|--------|------|-------|-----------|
|         | Existing Connections | Cembre | Lugs | Cable | Track Box |
| Box #11 | 6x500 Kcmil          | 7      | 6    | ~120' | By others |
| Box #12 | 3x500 Kcmil          | 4      | 3    |       | By others |

|         |                      |        |      |       |           |
|---------|----------------------|--------|------|-------|-----------|
|         | Existing Connections | Cembre | Lugs | Cable | Track Box |
| Box #10 | 6x500 Kcmil          | 7      | 6    | ~120' | By others |
| Box #9  | 3x500 Kcmil          | 4      | 3    |       | By others |

|        |                      |        |      |       |           |
|--------|----------------------|--------|------|-------|-----------|
|        | Existing Connections | Cembre | Lugs | Cable | Track Box |
| Box #7 | 2x500 Kcmil          | 3      | 2    | N/A   | By others |
| Box #8 | 2x500 Kcmil          | 3      | 2    |       | By others |

|        |                      |        |      |             |           |
|--------|----------------------|--------|------|-------------|-----------|
|        | Existing Connections | Cembre | Lugs | Cable to IB | Track Box |
| Box #1 | 2x500 Kcmil          | 3      | 2    | ~80'        | By others |
| Box #2 | 2x500 Kcmil          | 3      | 2    | ~100'       | By others |
| Box #3 | 2x500 Kcmil          | 3      | 2    | ~120'       | By others |
| IB     | 6x500 Kcmil          | N/A    | 6    | N/A         | N/A       |



|        | Existing Connections | Cembre | Lugs | Cable to IB | Track Box |
|--------|----------------------|--------|------|-------------|-----------|
| Box #6 | 2x500 Kcmil          | 3      | 2    | ~ 80'       | By others |
| Box #4 | 2x500 Kcmil          | 3      | 2    | ~100'       | By others |
| Box #5 | 2x500 Kcmil          | 3      | 2    | ~120'       | By others |
| IB     | 6x500 Kcmil          | N/A    | 6    | N/A         | N/A       |

\*Cembre quantities include one spare per track box.

### **Deliverables:**

The following deliverables are included in the scope of work:

| Deliverable                                                      | Due       |
|------------------------------------------------------------------|-----------|
| Step-by-step work plans and Job Hazard Analysis (JHA)            | 5/9/2025  |
| Safety & Testing Equipment Calibration Certification             | 5/9/2025  |
| Hour-by-hour Installation Schedule                               | 5/9/2025  |
| Pre-Construction Kick-off Meeting                                | 5/12/2025 |
| Acceptance Measurements                                          | 8/31/2025 |
| Test Reports                                                     | 8/31/2025 |
| Rice Interlocking Reconfiguration – Structural Erection Drawings | 8/31/2025 |
| As-in-service OCS plan set                                       | 8/31/2025 |

### **Execution Timeline**

An anticipated timeline for the execution of this scope of work is attached to this RFQ as “Appendix C – Execution Timeline”.

- Prefabrication efforts may occur prior to scheduled system shutdown if material is available.
- Rice Interlocking OCS Reconfiguration efforts must occur after completion of track work.

### **Assumptions**

- The scope and pricing of this proposal is based on UTA OCS Specifications for the Mid-Jordan Line dated 12/05/2008

### **Attachments**

- Appendix A – Materials
- Appendix B – Execution Timeline
- Appendix C – University Line OCS Upgrades and Maintenance Exhibit





This proposal is valid for 60 days, unless extended in writing by RMSS.  
If you need any additional information, please don't hesitate to contact us.

Sincerely,

Ozgun Yilmaz  
Project Engineer  
Rocky Mountain Systems Services

cc:

Marshall Wilson – RMSS  
Anthony Ortolani – RMSS  
Josh LaFleur - RMSS

Our pricing is in U.S. Dollars, F.O.B. Salt Lake City UT, and excludes all allowances, taxes, tariffs, licenses, and permits.



## Appendix A:

### Rice Interlocking Reconfiguration Permanent Materials

| Item No | Manuf. Part No | Description                           | Unit | Qty | Estimated Delivery Date |
|---------|----------------|---------------------------------------|------|-----|-------------------------|
| 63      | SHS34T         | SPLICE, HIGH SPEED, 350 MCM CW        | EA   | 5   | 3/13/2025               |
| 72      | 055375-3001    | CLAMP, CLEVIS 2" PIPE                 | EA   | 5   | 4/24/2025               |
| 80      | 700340-2       | CAP, 2" PIPE                          | EA   | 3   | 2/27/2025               |
| 93      | 056463-3002    | EYE, 2" SCH 40 PIPE                   | EA   | 3   | 2/27/2025               |
| 201     | 057183-3003    | SADDLE, INS. 2" PIPE (MESSENGER)      | EA   | 3   | 4/24/2025               |
| 459     | X              | PIPE, 2" SCH 40 AST A53 GRADED B      | FT   | 48  | 5/22/2025               |
| 91      | 0675026-8060   | STEADY ARM, UNINSULATED, LT. DUTY     | EA   | 3   | 5/8/2025                |
| 106     | 056909-3002    | TRANS*LITE TRUT 2" SCH 40             | EA   | 5   | 5/8/2025                |
| 205     | 674999         | CLAMP, INSULATED SWIVEL               | EA   | 3   | 4/24/2025               |
| 194     | 018988-3001    | CLAMP, UNIVERSAL FEEDER (2 BOLT)      | EA   | 62  | 4/24/2025               |
| 231     | 013853-3007    | CLAMP, DUPLEX .81"-1.19"              | EA   | 60  | 4/24/2025               |
| 22      | X              | 500 KCMIL SUPERFLEX CU BARE CABLE     | FT   | 207 | 2/27/2025               |
| 48      | 070776-2000    | EYE, BALL ANSI 52-5 30K               | EA   | 3   | 2/27/2025               |
| 73      | 055629-6150    | TRANS*LITE, E/E, 5/8", 15.00 LG       | EA   | 5   | 4/24/2024               |
| 117     | 057174-3001    | CLAMP, STRAIGHTLINE MESS              | EA   | 5   | 4/24/2025               |
| 220     | 014001-3007    | CLAMP, DEADEND 350 KCMIL              | EA   | 3   | 4/24/2025               |
| 294     | 087603-2000    | CLEVIS, SOCKET ANSI 52-3              | EA   | 3   | 4/24/2025               |
| 111     | 056997-3002    | GRIP, SPIRAL GUY, 1/2" EHS GALVANIZED | EA   | 10  | 3/13/2025               |
| 168     | 070709-2000    | SHACKLE, ANCHOR 3/4"                  | EA   | 3   | 4/24/2025               |
| 186     | 095683-3013    | TURNBUCKLE, .75" X 12" J/E            | EA   | 3   | 3/27/2025               |
| 503a    | 428-4-VM       | SLEEVE, 1/8" COMPRESSION              | EA   | 48  | 2/27/2025               |
| 656     | 6925960010     | CAP, CRIMP                            | EA   | 48  | 4/24/2024               |
| 521     | KMA-238-4      | CATENARY HANGER CLAMP - MAC           | EA   | 48  | 2/27/2025               |
| 502     | 301721         | INSULATED THIMBLE                     | EA   | 48  | 3/13/2025               |
| 277     | X              | WIRE ROPE, 0.13" 7X19 SS              | FT   | 120 | 2/27/2025               |
| 249     | 057603-3001    | CONNECTOR, SPLIT-BOLT                 | EA   | 39  | 2/27/2025               |
| 250     | 055412-4001    | ARMOR, 5/8" ROD                       | EA   | 5   | 2/27/2025               |



| Item No | Manuf. Part No | Description                             | Unit | Qty | Estimated Delivery Date |
|---------|----------------|-----------------------------------------|------|-----|-------------------------|
| 394     | 057431-4001    | ROPE, SYNTHETIC 0.305 DIA.              | FT   | 58  | 5/22/2025               |
| 428     | 056626-4002    | THIMBLE, 0.31" OPEN                     | EA   | 10  | 5/22/2025               |
| 637     | TBC-LP-A02     | TURNBUCKLE, LOOP TYPE, BRZ BODY. SS HDW | EA   | 10  | 5/22/2025               |
| 792     | 700300-27X     | SECTION INSULATOR - TYPE KF             | EA   | 3   | 4/24/2025               |
| 795     | 700360-1X      | SUPPORT, TYPE KF SEC. INS               | EA   | 5   | 4/24/2025               |
| 797     | 060470-6200    | JUMPER, TYPE KF, SECTION INS.           | EA   | 5   | 4/24/2025               |
| 799     | 700391-X       | RUNNER, TYPE KF SEC INS                 | EA   | 5   | 4/24/2025               |
| 802     | 055629-6540    | TRANS*LITE E/E, 0.63" 54.00 LG          | EA   | 3   | 4/24/2025               |
| 488     | 056048-3003    | CLAMP, CONTACT BRIDGE                   | EA   | 5   | 2/27/2025               |
| 489     | X              | PIPE 0.5: IPS SCH 40 (BRASS)            | FT   | 15  | 4/24/2024               |
| 104     | 056626-4004    | THIMBLE, 1/2" OPEN                      | EA   | 10  | 2/27/2025               |
| N/A     | X              | BA-10 Termination Brackets              | EA   | 4   | 5/22/2025               |
| N/A     | X              | 1/2" Galvanized EHS Steel Guy Strand    | Ft   | 72  | 5/22/2025               |
| N/A     | X              | 3/8" Galvanized EHS Steel Guy Strand    | Ft   | 250 | 5/22/2025               |
| N/A     | X              | 350 KCMIL CONTACT WIRE                  | Ft   | 100 | 2/27/2025               |



## OCS Maintenance Permanent Materials

| Item No | Manuf. Part No | Description                                  | Unit | Qty  | Estimated Delivery Date |
|---------|----------------|----------------------------------------------|------|------|-------------------------|
| 225/III | SHS34T         | SPLICE, HIGH SPEED, 350 MCM CW               | Ea   | 12   | 2/15/2025               |
| #201    | 057183-3003    | SADDLE, INS. 2" PIPE (MESSENGER)             | Ea   | 302  | 2/15/2025               |
| #85     | 056088-4004    | SLEEVE, 3/8" COMPRESSION                     | Ea   | 77   | In Stock                |
| #103    | 056626-4003    | THIMBLE, 3/8" OPEN                           | Ea   | 82   | In Stock                |
| N/A     | X              | WIRE ROPE, .38" STAINLESS STEEL              | Ft   | 500  | In Stock                |
| #191    | 059006-3002    | SADDLE, DOUBLE INS. 2" PIPE                  | Ea   | 60   | 2/15/2025               |
| #205    | 674999         | CLAMP, INSULATED SWIVEL                      | Ea   | 182  | 2/15/2025               |
| N/A     | X              | WIRE ROPE, .25" STAINLESS STEEL              | Ft   | 505  | In Stock                |
| #84     | 056088-4002    | SLEEVE, 1/4" COMPRESSION                     | Ea   | 257  | 2/15/2025               |
| #73     | 055629-6150    | TRANS*LITE, E/E, 5/8", 15.00 LG              | Ea   | 29   | 2/15/2025               |
| #220    | 014001-3007    | CLAMP, DEADEND 350 KCMIL                     | Ea   | 3    | 2/15/2025               |
| #111    | 056997-3002    | GRIP, SPIRAL GUY, 1/2" GALV                  | Ea   | 44   | 2/15/2025               |
| #168    | 070709-2000    | SHACKLE, ANCHOR 3/4"                         | Ea   | 15   | 2/15/2025               |
| #186    | 095683-3013    | TURNBUCKLE, .75" X 12" J/E                   | Ea   | 15   | 2/15/2025               |
| #706    | OTC34T         | HANGER CONTACT WIRE CLAMP                    | Ea   | 129  | 2/15/2025               |
| #707    | 301721         | INSULATED THIMBLE                            | Ea   | 129  | 2/15/2025               |
| #104    | 056626-4004    | THIMBLE, 1/2" OPEN                           | Ea   | 82   | 2/15/2025               |
| N/A     | X              | 1/2" Galvanized EHS Steel Guy Strand         | Ft   | 2400 | In Stock                |
| #614    | 6925960030     | CAP, CRIMP 0.25" Dia                         | Ea   | 257  | 2/15/2025               |
| #616    | 0135/06/K55    | 0.25" OPEN THIMBLE                           | Ea   | 129  | 2/15/2025               |
| #705    | MHC81-19       | MESSENGER HANGER CLAMP                       | Ea   | 129  | 2/15/2025               |
| #145    | 058867-3001    | STRANDVISE, 0.5" Galvanized                  | Ea   | 29   | 2/15/2025               |
| #296    | 056574-3007    | CLIP, 0.88 GUY OUTLINE U-Bolt                | Ea   | 56   | 2/15/2025               |
| #224    | 015332-2000    | CLAMP, STRAIN 500 KCMIL OFFSET, HDG          | Ea   | 15   | 2/15/2025               |
| #199/I  | 135/15/T79/II  | STRAIN CLAMP, CW                             | Ea   | 20   | 1/15/2025               |
| 171/I   | 135/14/LA1     | LIGHTNING ARRESTOR 750 VDC, 970 MCOV         | Ea   | 15   | 2/15/2025               |
| N/A     | X              | 350 KCMIL CONTACT WIRE                       | Ft   | 2500 | In Stock                |
| #345    | 057183-3004    | MESSENGER SADDLE, SINGLE, STITCH BRIDLE, HDG | Ea   | 12   | 2/15/2025               |



## Tensorex C+ OCS Spring Tensioner Permanent Materials

| Item No | Manuf. Part No | Description                                    | Unit | Qty | Estimated Delivery Date |
|---------|----------------|------------------------------------------------|------|-----|-------------------------|
| 194     | 018988-3001    | CLAMP, UNIVERSAL FEEDER (2 BOLT)               | Ea   | 77  | 4/24/2024               |
| 231     | 013853-3007    | CLAMP, DUPLEX .81"-1.19"                       | Ea   | 58  | 4/24/2025               |
| 22      | N/A            | 500 KCMIL SUPERFLEX CU BARE CABLE              | Ft   | 231 | 2/27/2025               |
| 48      | 070776-2000    | EYE, BALL ANSI 52-5 30K                        | Ea   | 44  | 2/27/2025               |
| 73      | 055629-6150    | TRANS*LITE, E/E, 5/8", 15.00 LG                | Ea   | 68  | 4/24/2025               |
| 294     | 087603-2000    | CLEVIS, SOCKET ANSI 52-3                       | Ea   | 44  | 2/27/2025               |
| 75      | 055709-6150    | TRANS*LITE, C/E, 5/8", 15.00 LG                | Ea   | 10  | 4/24/2025               |
| 105     | 056626-4005    | THIMBLE, 5/8" OPEN                             | Ea   | 77  | 2/27/2025               |
| 302     | 057464-4002    | WIRE ROPE, 7 STRAND 1/2" EHS GALVANIZED        | Ft   | 768 | 5/22/2025               |
| 111a    | 056997-3002    | GRIP, SPIRAL GUY, 1/2" EHS GALVANIZED          | Ea   | 77  | 3/13/2025               |
| 186     | 095683-3013    | TURNBUCKLE, .75" X 12" J/E                     | Ea   | 39  | 3/27/2025               |
| 463     | 057196-4001    | PLATE, YOKE (3K X 6K)                          | Ea   | 5   | 3/13/2025               |
| 503a    | 428-4-VM       | SLEEVE, 1/8" COMPRESSION                       | Ea   | 144 | 2/27/2025               |
| 656     | 6925960010     | CAP, CRIMP                                     | Ea   | 144 | 4/24/2024               |
| 521     | KMA-238-4      | CATENARY HANGER CLAMP - MAC                    | Ea   | 144 | 2/27/2025               |
| 502     | 301721         | INSULATED THIMBLE                              | Ea   | 144 | 3/13/2025               |
| 277     | N/A            | WIRE ROPE, 0.13" 7X19 SS                       | Ft   | 360 | 2/27/2025               |
| 88      | 043054-03      | Bracket for 2xTRC+ Round Internal BWA Pole     | Ea   | 14  | 5/8/2025                |
| 89      | 043054-04      | Bracket for TRC+ Round Internal B              | Ea   | 6   | 5/8/2025                |
| 90      | N/A            | Backing Plate                                  | Ea   | 20  | 3/13/2025               |
| 78      | N/A            | 3/4" All Thread Rod W/ Washers and Double Nuts | Set  | 20  | 3/13/2025               |
| 84      | 701142-TB12420 | TENSOREX C+ 33.4 IN, 3000LBS                   | Ea   | 5   | 5/8/2025                |
| 85      | 701141-TB12420 | TENSOREX C+ 33.4 IN, 6000LBS                   | Ea   | 9   | 5/8/2025                |
| 86      | 701360-TB12420 | TENSOREX C+ 40.9 IN, 3000LBS                   | Ea   | 9   | 5/8/2025                |
| 87      | 701423-TB12420 | TENSOREX C+ 40.9 IN, 6000LBS                   | Ea   | 9   | 5/8/2025                |
| N/A     | X              | 1/8" 7x19 Stainless Steel Wire Rope            | Ft   | 480 | 2/27/2025               |
| 463     | 057196-4001    | PLATE, YOKE (3K x 6K)                          | EA   | 5   | 3/13/2025               |

[illegible]


**\*\* Execution timeline is subject to change based on collaborative scheduling efforts with owner and other contractors leading up to shutdown activities.**

[illegible]


**\*\* Execution timeline is subject to change based on collaborative scheduling efforts with owner and other contractors leading up to shutdown activities.**

I:\LRT PROJECTS\University LRT Project\U-Line As-Built\October 2002\System\OC155AB.dwg, Layout1, 12/29/2005 09:06:22 AM, Carlee Slama

C:\University LRT Extension Project\HMA AS BUILT\OC155AB.dwg\Npurification 02-12-02 16:22:18

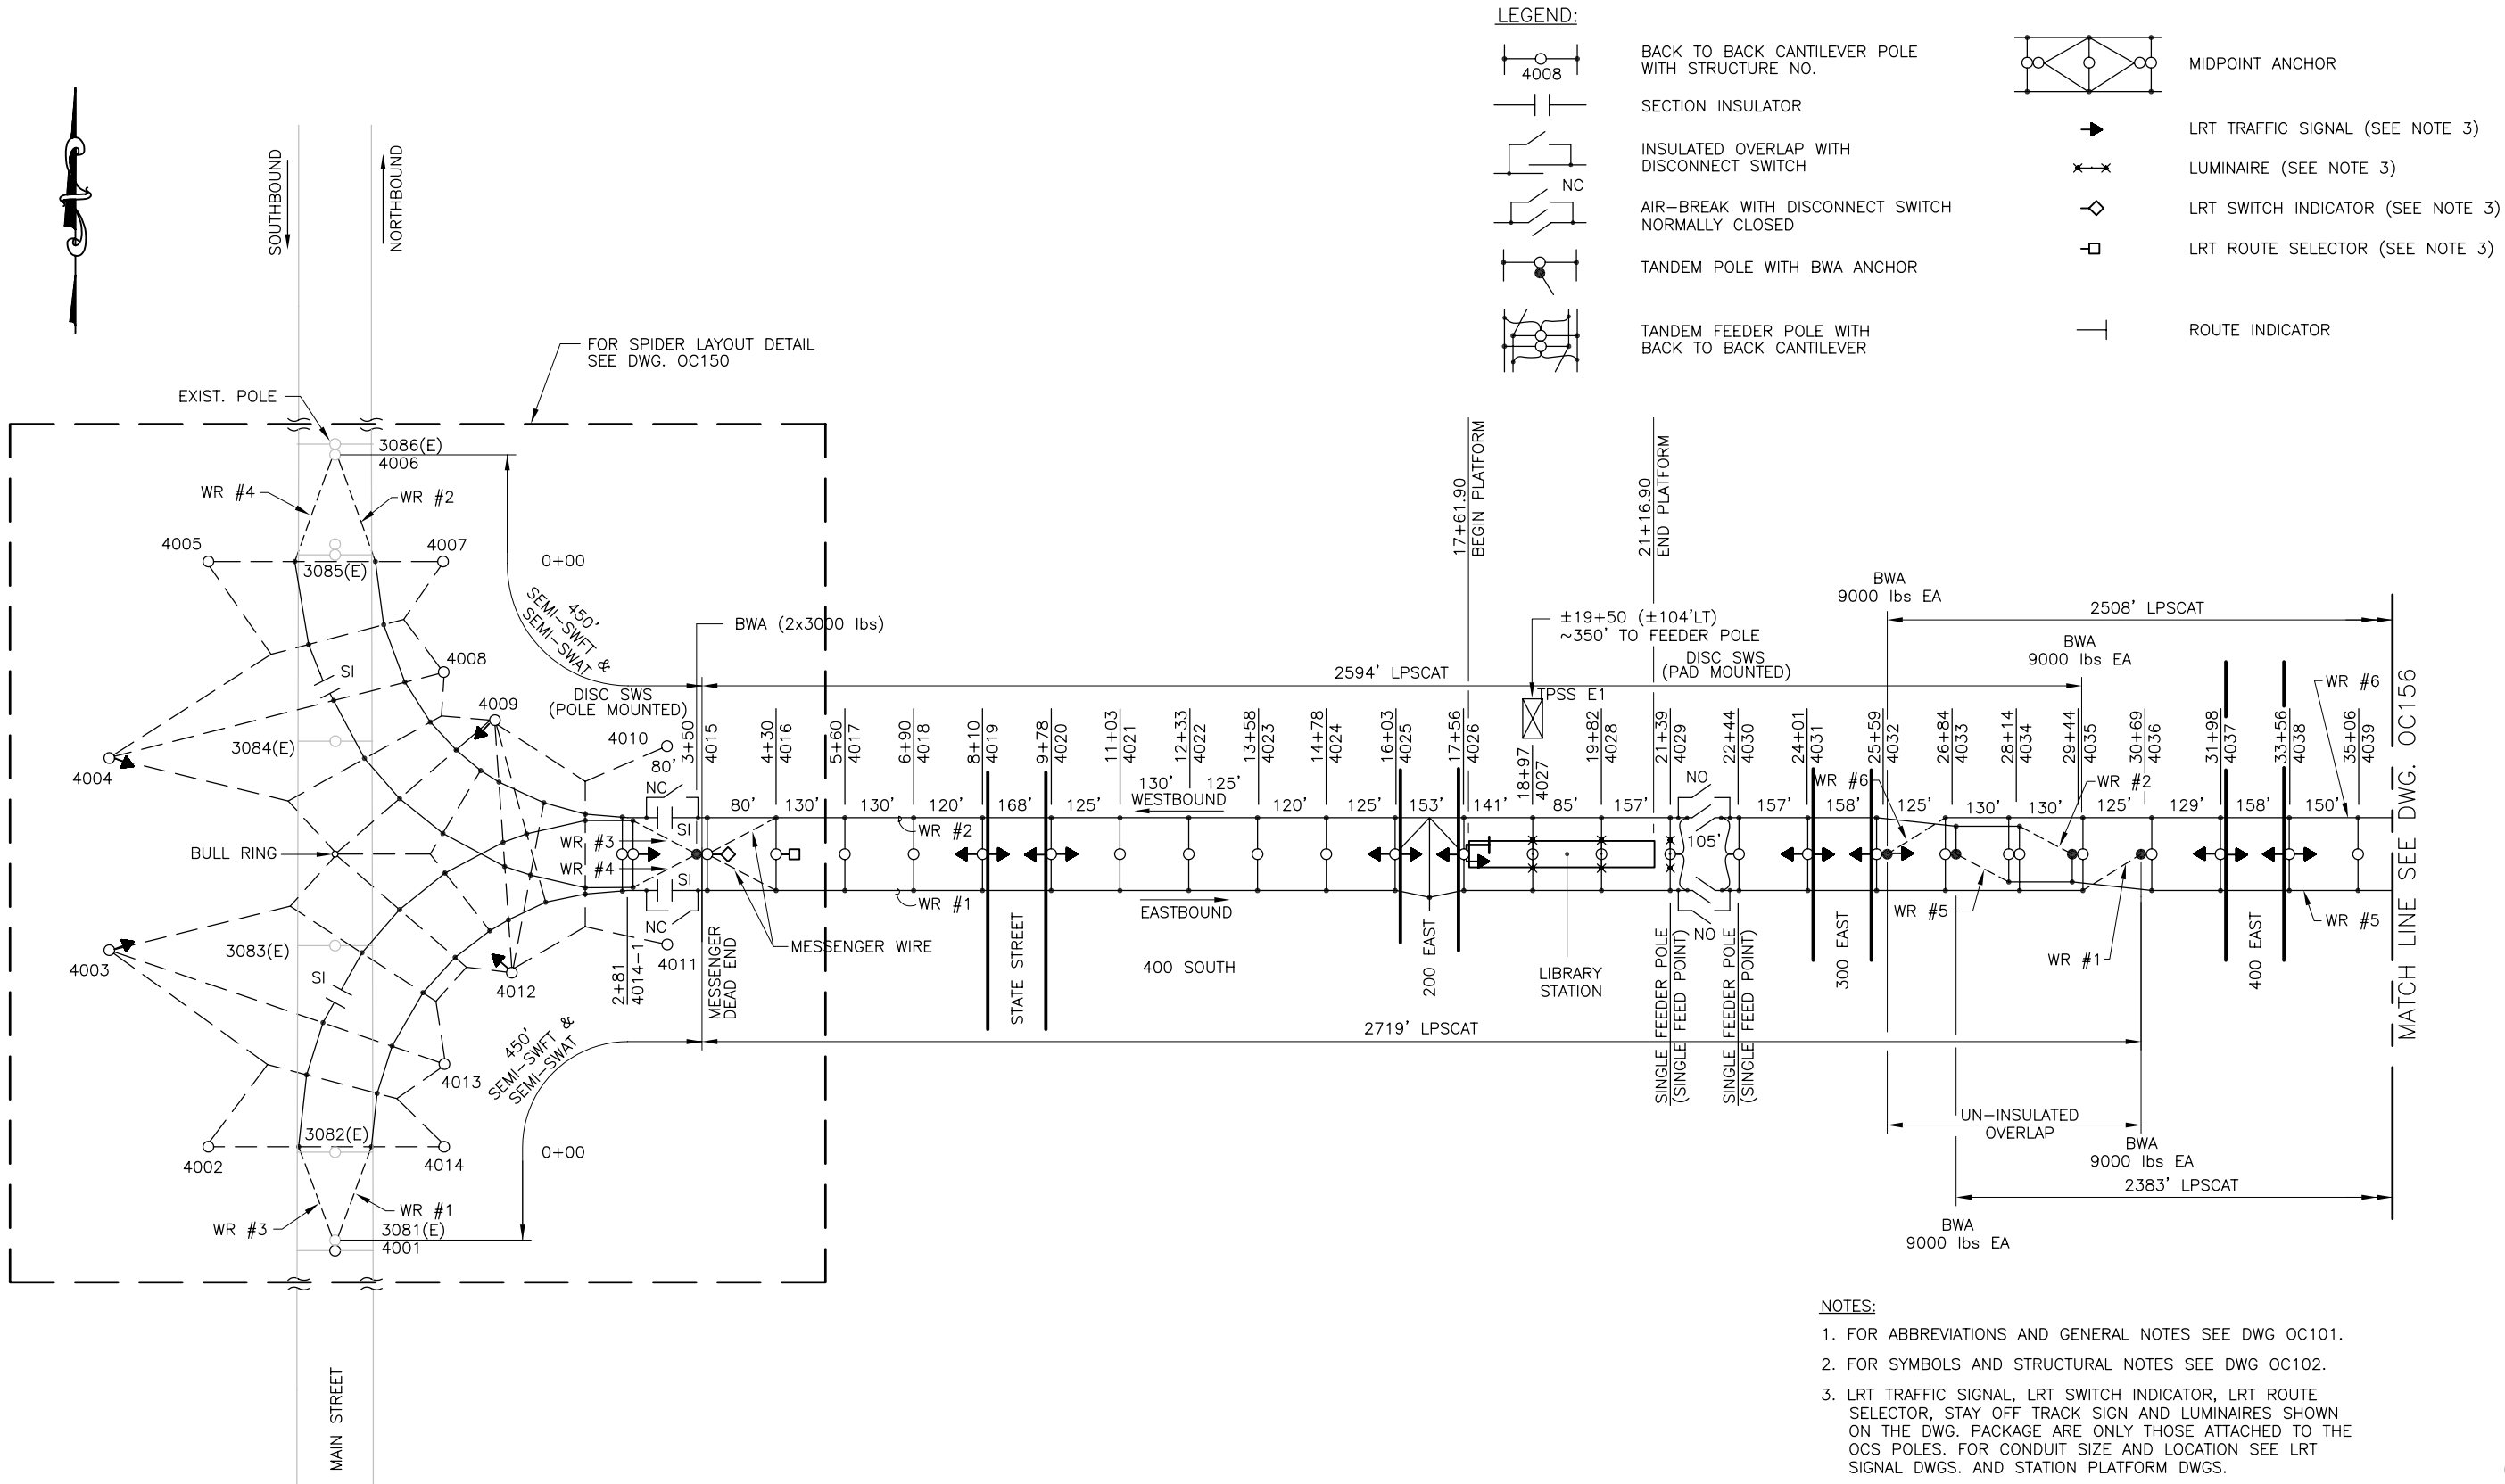

| REV            | DATE    | Description                       |
|----------------|---------|-----------------------------------|
| 6              | 2/15/02 | AS-BUILT                          |
| REVISION BLOCK |         |                                   |
| 5              | 8/24/01 | DELETED STAY OFF-TRACK SIGN       |
| 4              | 5/4/01  | DELETED STRUCTURES 4025-1, 4026-1 |
| 3              | 3/30/01 | INCORPORATED LATEST COMMENTS      |
| 2              | 3/2/01  | ADDED LUMINAIRE ON OCS POLES      |
| 1              | 12/7/00 | ISSUED FOR CONSTRUCTION           |

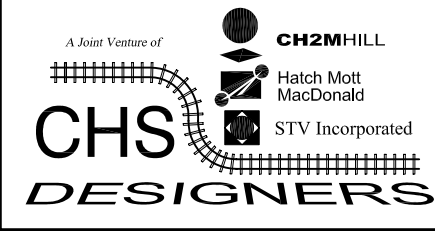

|              |                 |
|--------------|-----------------|
| Designed By: | G. TERRADO      |
| Drawn By:    | N. PURIFICACION |
| Checked By:  | G. EYZAGUIRRE   |
| Approved By: | J. ADELA        |


|                                |       |                   |                 |
|--------------------------------|-------|-------------------|-----------------|
| <b>OVERHEAD CONTACT SYSTEM</b> |       | Scale:            | NTS             |
| MASTER SCHEMATIC LAYOUT        |       | CADD Filename:    | OC155AB.DWG     |
| SHEET 1 OF 3                   |       | Submittal Date:   | 12/07/00        |
|                                |       | UTA Contract No.: | UT99-05VT-DB WE |
| Drawing No.:                   | OC155 | Sheet No.:        | 56              |





I:\LRT PROJECTS\University LRT Project\U-Line As-Built\October 2002\System\OC156AB.dwg, Layout1, 12/29/2005 09:05:59 AM, Carlee Slama


C:\University LRT Extension Project\HMA\AS BUILT\OC156AB.dwg\Npurification 02-12-02 17:15:10

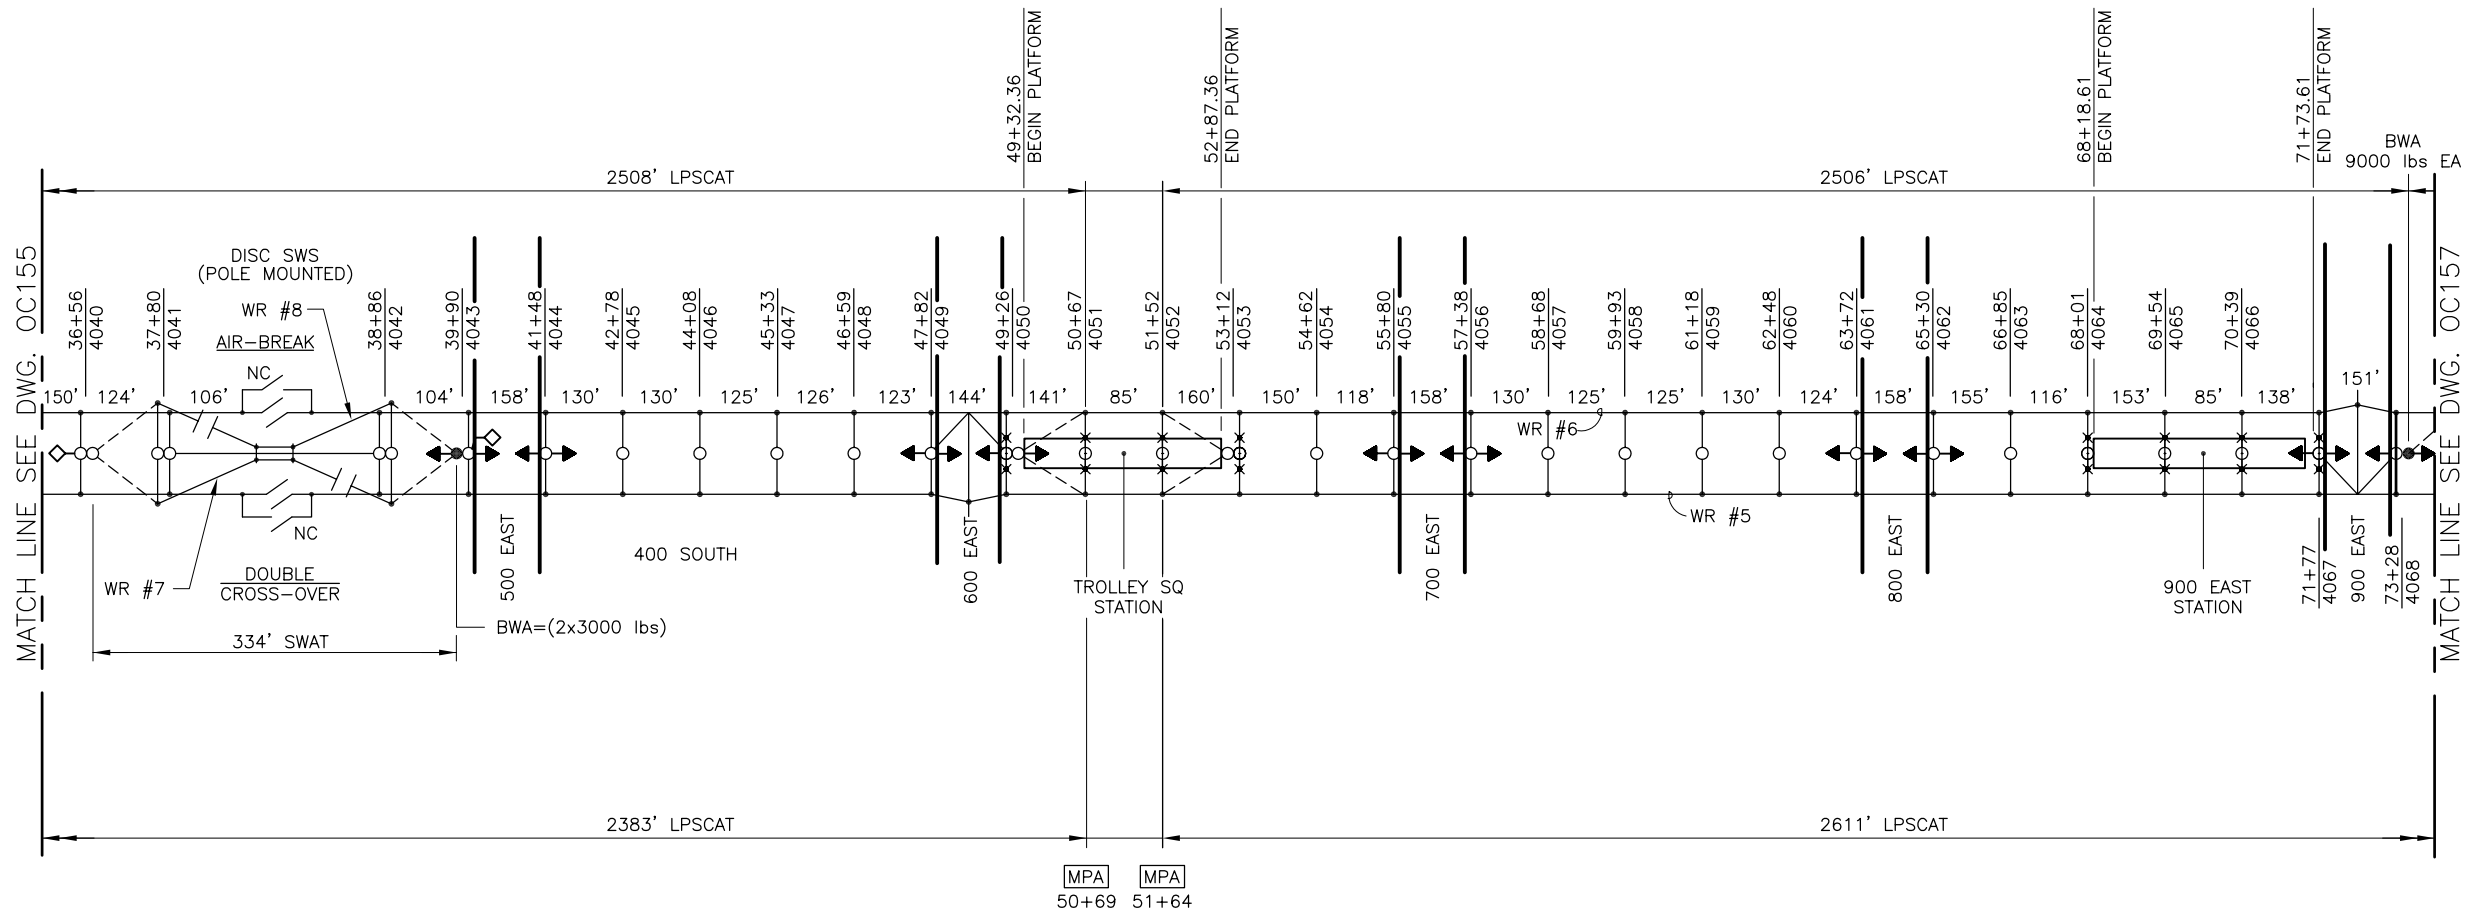

- NOTES:
1. FOR ABBREVIATIONS AND GENERAL NOTES SEE DWG OC101.
  2. FOR SYMBOLS AND STRUCTURAL NOTES SEE DWG OC102.



| REVISION BLOCK |         |                                                                            |
|----------------|---------|----------------------------------------------------------------------------|
| REV            | DATE    | Description                                                                |
| 6              | 2/15/02 | AS-BUILT                                                                   |
| 5              | 8/24/01 | DELETED STAY-OFF TRACK SIGN/ADDITION OF PUSH-OFF ASSEMBLY AT 600 E & 900 E |
| 2              | 3/2/01  | ADDED LUMINAIRE ON OCS POLES                                               |
| 0              | 12/7/00 | ISSUED FOR CONSTRUCTION                                                    |

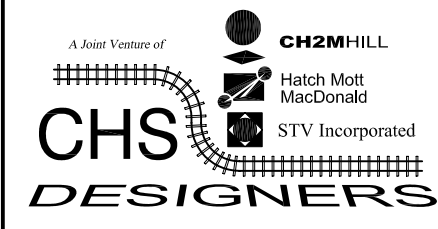


|                 |
|-----------------|
| Designed By:    |
| G. TERRADO      |
| Drawn By:       |
| N. PURIFICACION |
| Checked By:     |
| G. EYZAGUIRRE   |
| Approved By:    |
| J. ADELA        |

|                         |  |
|-------------------------|--|
| OVERHEAD CONTACT SYSTEM |  |
| MASTER SCHEMATIC LAYOUT |  |
| SHEET 2 OF 3            |  |


|                   |                 |
|-------------------|-----------------|
| Scale:            | NTS             |
| CADD Filename:    | OC156AB.DWG     |
| Submittal Date    | 12/07/00        |
| UTA Contract No.: | UT99-05VT-DB WE |
| Drawing No.:      | OC156           |
| Sheet No.:        | 57              |

I:\LRT PROJECTS\University LRT Project\U-Line As-Built\October 2002\System\OC157AB.dwg, Layout1, 12/29/2005 09:05:35 AM, Carlee Slama

C:\University LRT Extension Project\HMA AS BUILT\OC157AB.dwg\Npurification 02-12-02 16:34:14

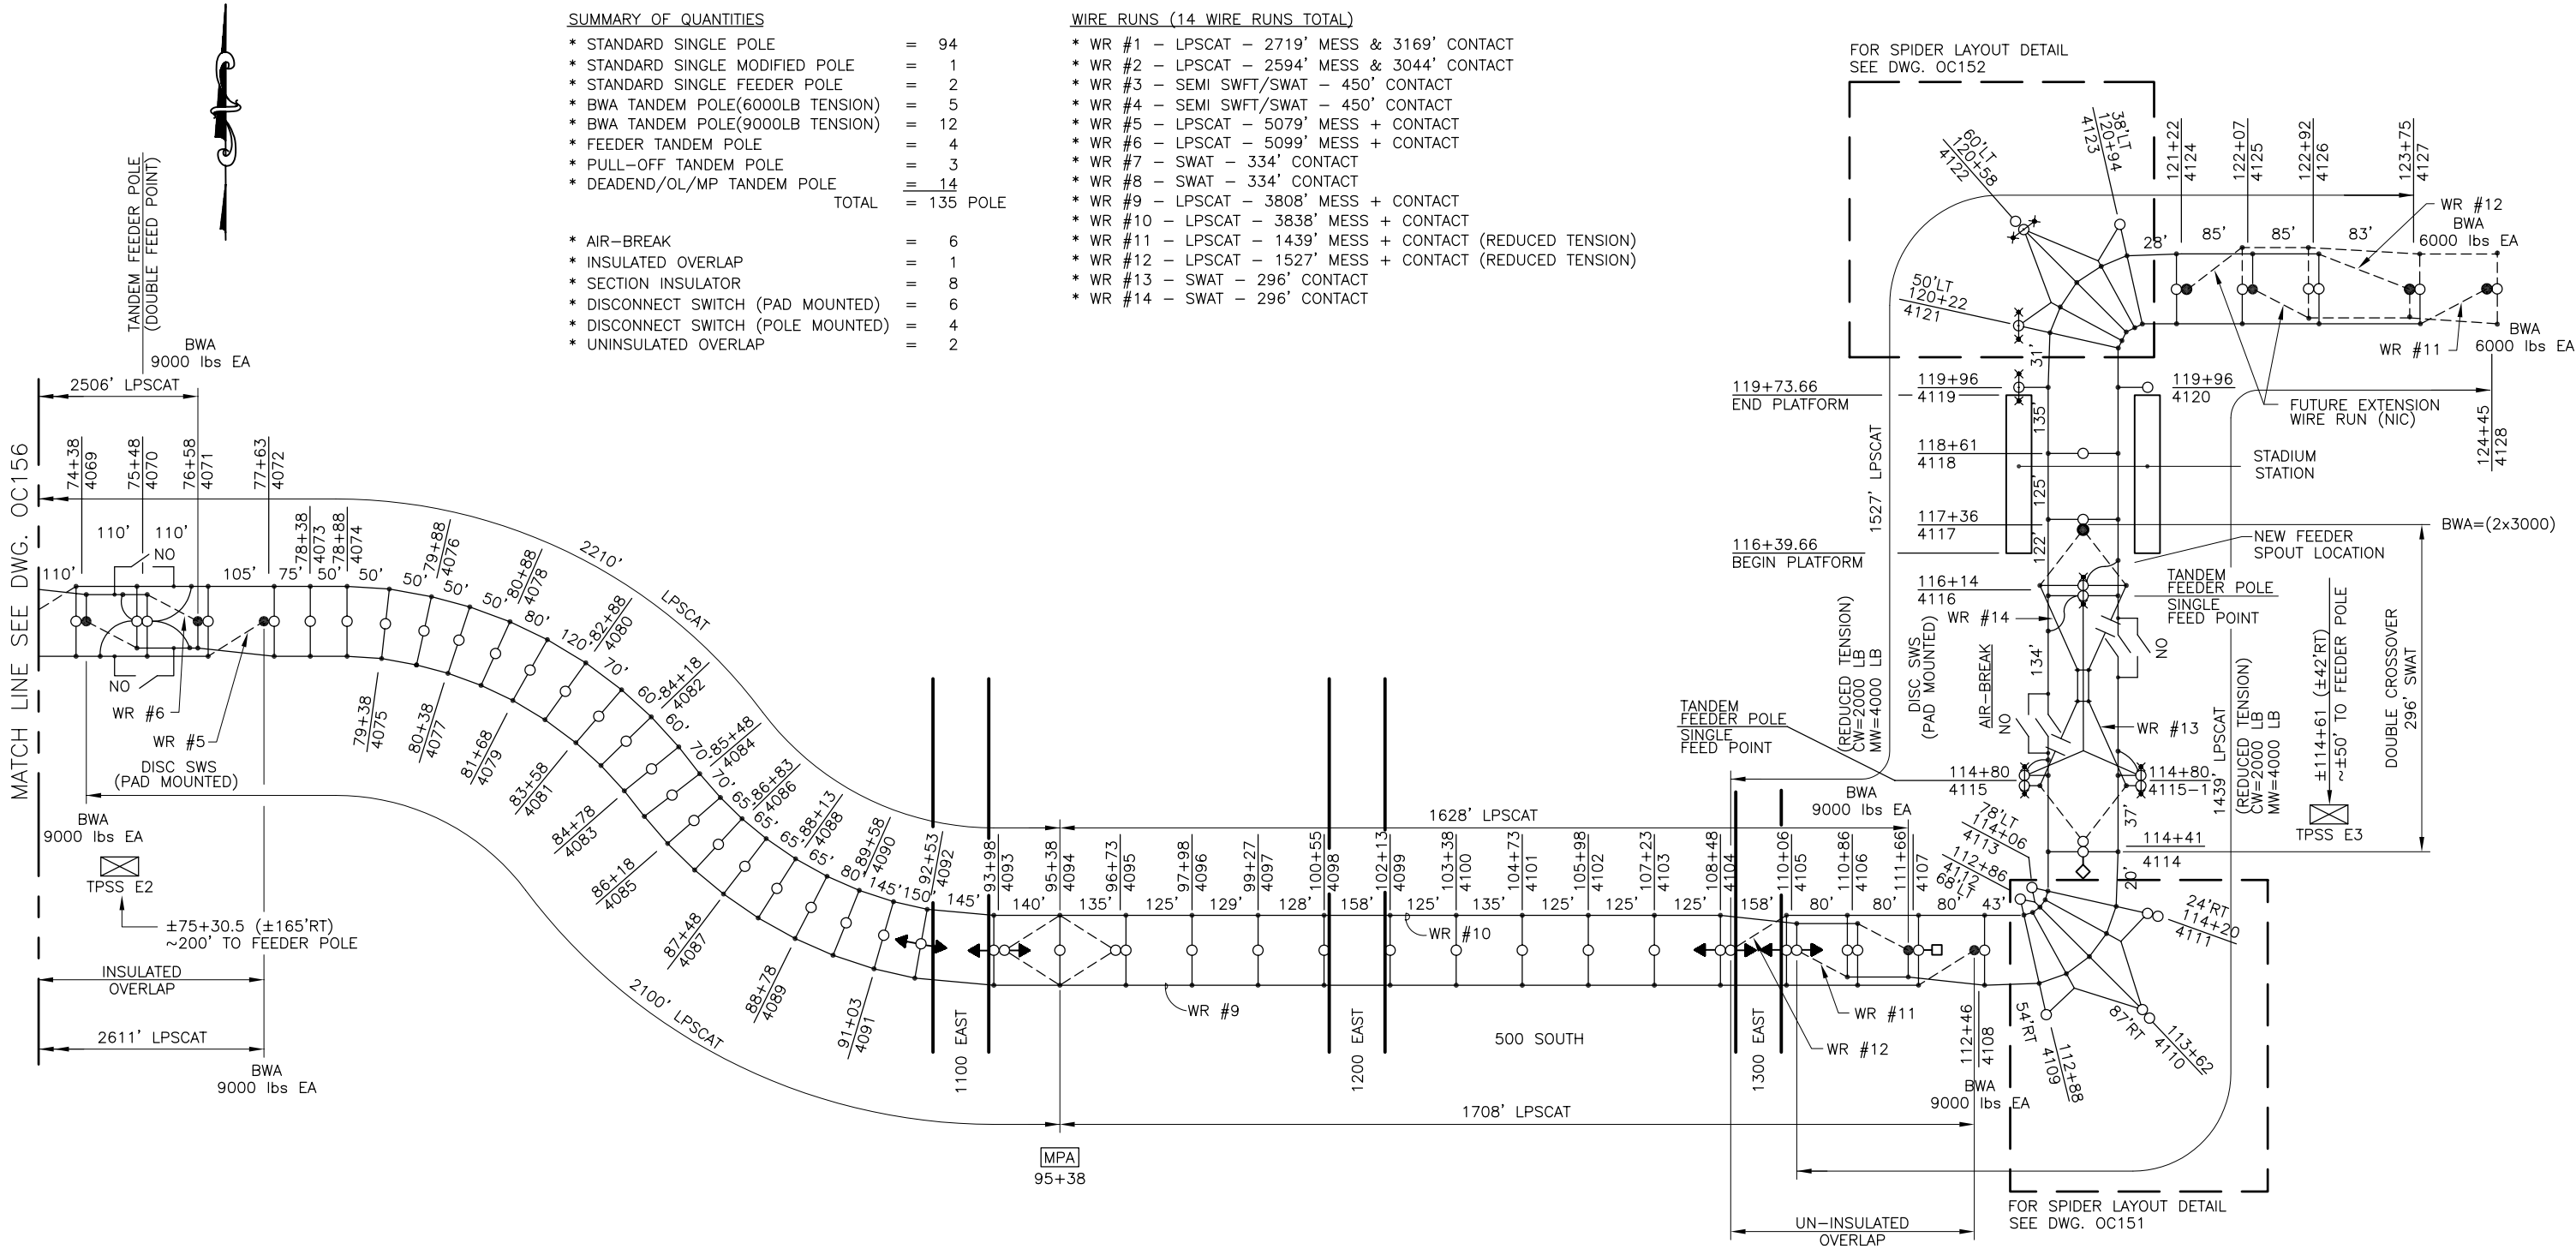

| REVISION BLOCK |          |                                              |
|----------------|----------|----------------------------------------------|
| 6              | 2/15/02  | AS-BUILT                                     |
| 5              | 8/24/01  | DELETED STAY-OFF TRACK SIGN/ADDED NEW FEEDER |
| 2              | 3/2/01   | INCORPORATED LATEST CHANGES                  |
| 1              | 12/28/00 | INCORPORATED LATEST CHANGES/CHANGE ORDER     |
| 0              | 12/7/00  | ISSUED FOR CONSTRUCTION                      |
| REV            | DATE     | Description                                  |

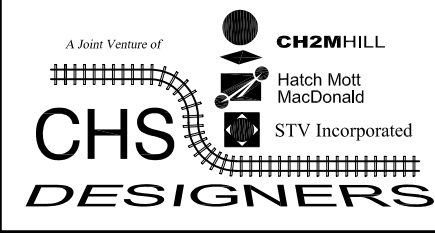


|              |                 |
|--------------|-----------------|
| Designed By: | G. TERRADO      |
| Drawn By:    | N. PURIFICACION |
| Checked By:  | G. EYZAGUIRRE   |
| Approved By: | J. ADELA        |

| OVERHEAD CONTACT SYSTEM                 |                 |
|-----------------------------------------|-----------------|
| MASTER SCHEMATIC LAYOUT<br>SHEET 3 OF 3 |                 |
| Scale:                                  | NTS             |
| CADD Filename:                          | OC157AB.DWG     |
| Submittal Date                          | 12/07/00        |
| UTA Contract No.:                       | UT99-05VT-DB WE |
| Drawing No.:                            | OC157           |
| Sheet No.:                              | 58              |



### TANDEM FEEDER POLE WITH BACK TO BACK CANTILEVER

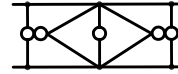


STREET LUMINAIRE = (SL)







- \* STANDARD SINGLE POLE
- \* BWA TANDEM POLE
- \* STANDARD TANDEM POLE
- \* SECTION INSULATOR
- \* POLE MOUNTED DISCONNECT
- \* PAD MOUNTED DISCONNECT
- \* NO OF WIRE RUNS
- \* NO OF SPRING LOADED  
TROLLEY RUNS

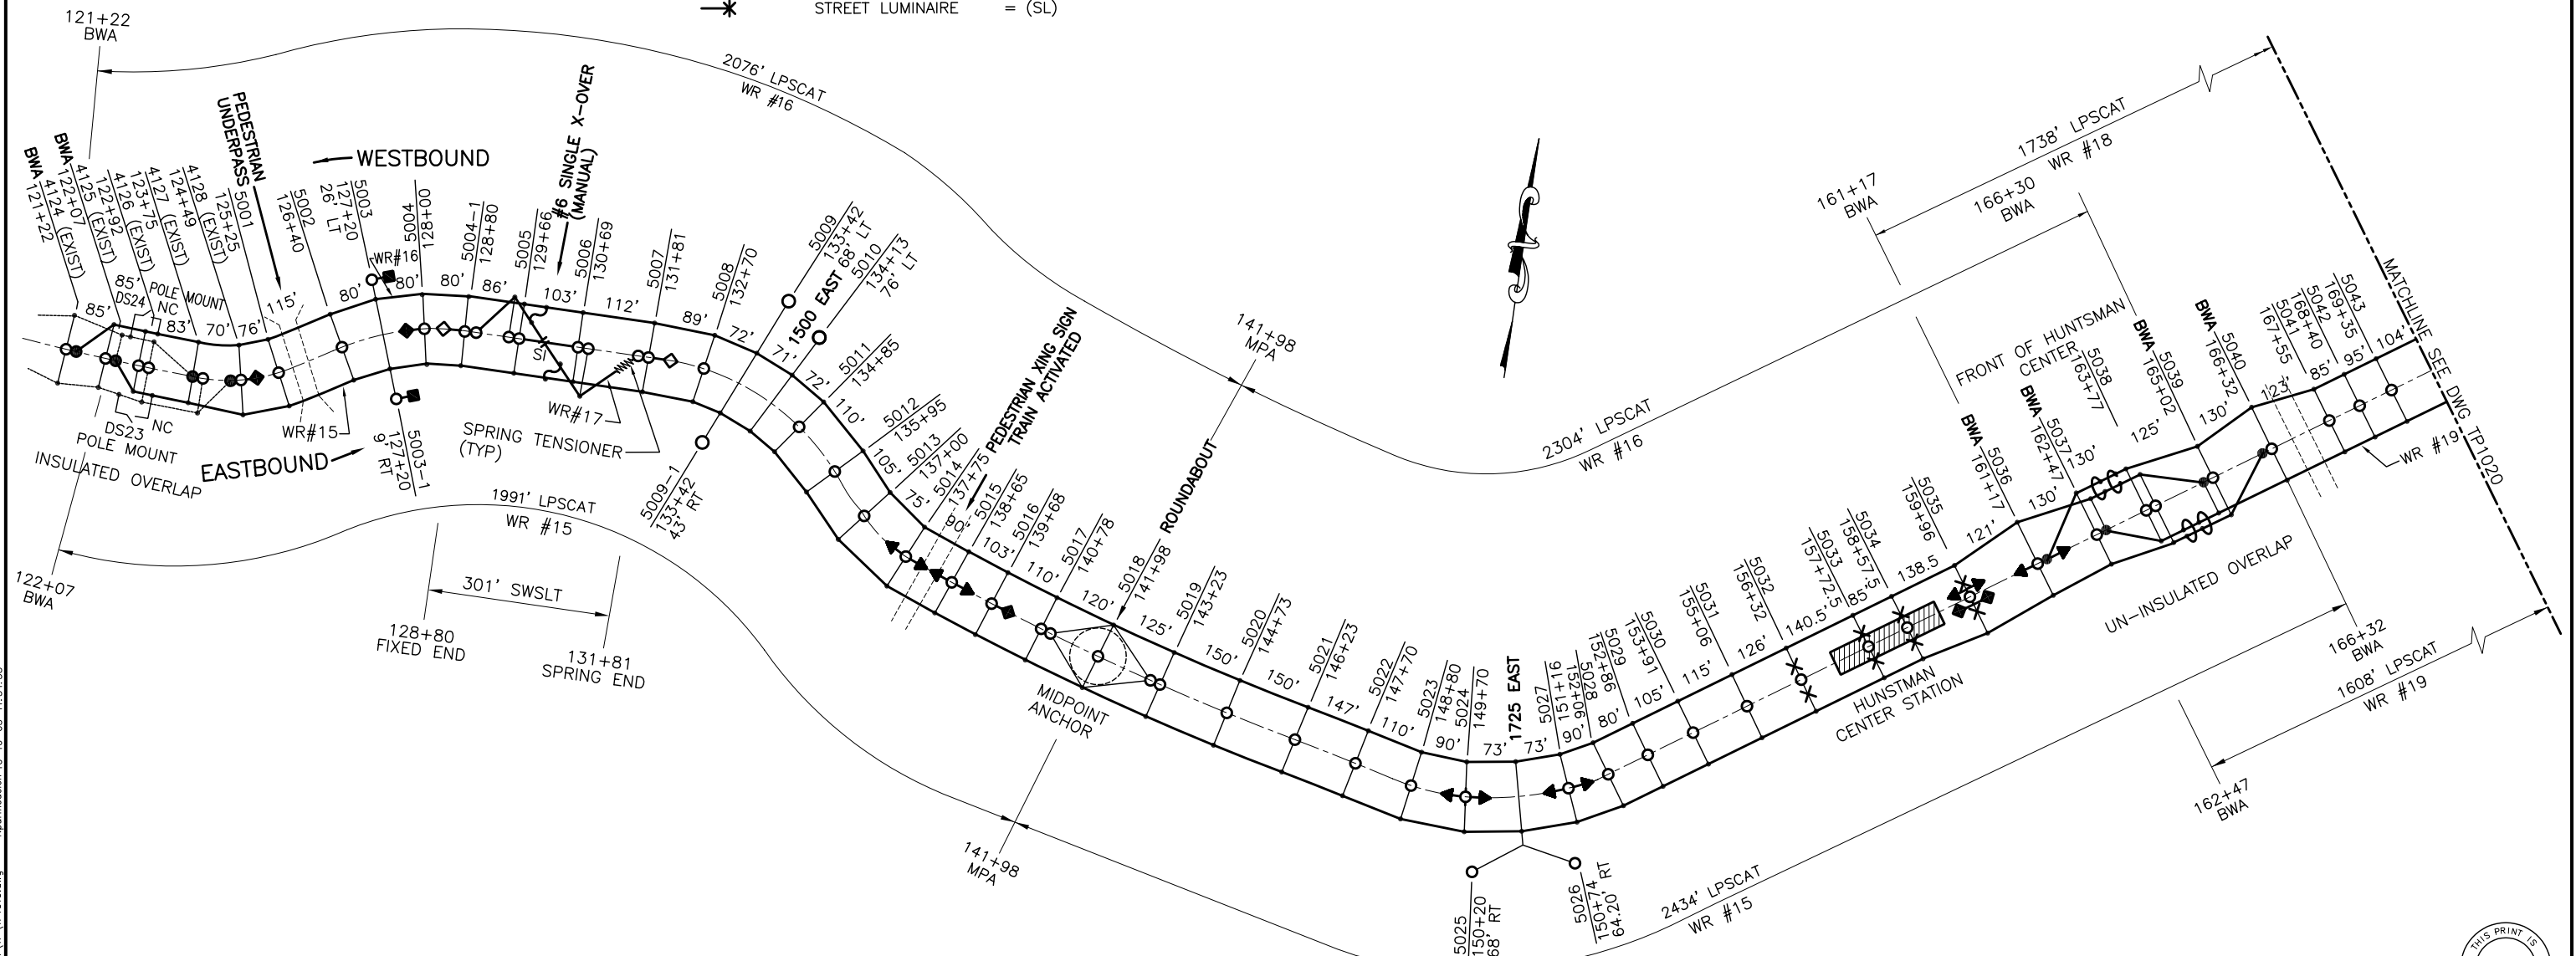
= 61  
 = 6  
 = 17  
 = 3  
 = 4  
 = 8  
 = 7  
 = 3

TOT=84 POLES

\* WR #15 – LPSCAT – 4425’ MESS & CONTACT  
 \* WR #16 – LPSCAT – 4380’ MESS & CONTACT  
 \* WR #17 – SWSLT – 301’ CONTACT  
 \* WR #18 – LPSCAT – 3798’ MESS & CONTACT  
 \* WR #19 – LPSCAT – 4508’ MESS & CONTACT  
 \* WR #20 – SWSLT – 425’ CONTACT  
 \* WR #21 – SWSLT – 425’ CONTACT



|                                                                                     |          |                                |
|-------------------------------------------------------------------------------------|----------|--------------------------------|
|  |          |                                |
|  | 10/15/03 | AS-BUILT                       |
|  | 2/18/02  | INCORPORATE CHANGE ORDER - IFC |
|  | 11/12/02 | INCORPORATE UTA COMMENTS       |
|  | 8/09/02  | INCORPORATE IFC COMMENTS       |
|  | 6/14/02  | ISSUED FOR CONSTRUCTION        |
| REV                                                                                 | DATE     | Description                    |

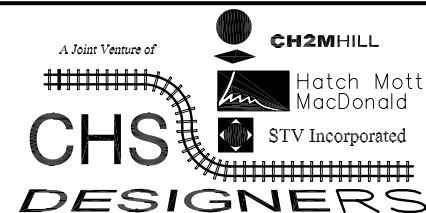



|              |                 |
|--------------|-----------------|
| Designed By: | G. TERRADO      |
| Drawn By:    | N. PURIFICACION |
| Checked By:  | G. EYZAGUIRRE   |
| Approved By: | J. ADELA        |

MASTER SCHEMATIC LAYOUT  
& FEEDING ARRANGEMENT  
SHEET 1 OF 2

|                                      |            |
|--------------------------------------|------------|
| Scale:<br>NTS                        |            |
| CADD Filename<br>TP1019.DWG          |            |
| Submittal Date<br>06/14/02           |            |
| UTA Contract No.:<br>UT99-05VT-DB WE |            |
| Drawing No.:<br>TP1019               | Sheet No.: |

P:\SLOrill\MED CENTER EXT\CAD\Systems\AS BUILT\TP1020.dwg Npurification 10-16-03 11:35:38

| REV | DATE     | Description                    |
|-----|----------|--------------------------------|
| 4   | 10/15/03 | AS-BUILT                       |
| 3   | 02/28/03 | INCORPORATE CHANGE ORDER - IFC |
| 2   | 11/12/02 | INCORPORATE UTA COMMENTS       |
| 1   | 08/09/02 | INCORPORATE IFC COMMENTS       |
| 0   | 06/14/02 | ISSUED FOR CONSTRUCTION        |

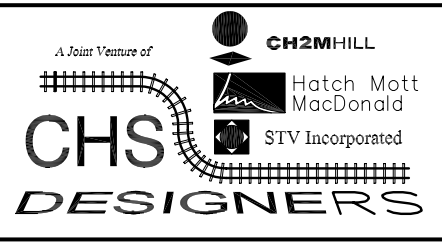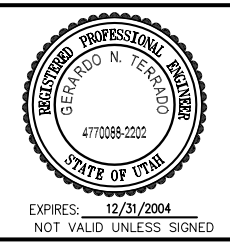

|              |                 |
|--------------|-----------------|
| Designed By: | G. TERRADO      |
| Drawn By:    | N. PURIFICACION |
| Checked By:  | G. EYZAGUIRRE   |
| Approved By: | J. ADELA        |

OVERHEAD CONTACT SYSTEM

MASTER SCHEMATIC LAYOUT  
& FEEDING ARRANGEMENT  
SHEET 2 OF 2

|                   |                 |
|-------------------|-----------------|
| Scale:            | NTS             |
| CADD Filename     | TP1020.DWG      |
| Submittal Date    | 06/14/02        |
| UTA Contract No.: | UT99-05VT-DB WE |
| Drawing No.:      | TP1020          |
| Sheet No.:        |                 |

